

### UTILITIES - UNDERGROUND INVESTIGATIONS

#### ABBREVIATIONS & SYMBOLS

DC	Drain Chamber	CP	Cable Chamber	ED	End of Trace
DL	Drain Line	CL	Cable Line	EB	External Boundary
AR	Assured Route	DD	Depth To Down	EL	External Level
BL	Base Level	DT	Depth To Top	EBL	External Boundary
CB	Concrete Box	DB	Depth To Surface	RCB	Rectangular Cable Chamber
CC	Cable Core Chamber	DTB	Depth To Base	SL	Sub Level
CCD	Cable Core Chamber	DTH	Depth To Head	SLL	Sub Level
CL	Cable Line	DTE	Depth To Edge	UL	Under To Line
				TR	Taken From Records
				EBL	External Boundary

**DRAWING NOTES**

All below ground details shown have been identified from above ground without excavation. Survey Solutions use electromagnetic and/or ground penetrating radar (GPR) methods to investigate underground utilities, services and features. Results using these methods are not reliable and we recommend trial excavations are carried out to confirm any identifications, positions and depths.

Any areas on the drawing where services or features have not been shown are not necessarily clear of services or features but are an indication that no items have been identified during our investigations. All reasonable care and normal good practice should still be employed during design and construction processes.

Certain types of services such as plastic or concrete pipes, some conduit and ducting where direct access can not be achieved for tracing may not be shown and alternative costing methods should be used.

Survey Solutions has used all reasonable care to research available service records, but the completeness or use of the service records supplied to or by Survey Solutions cannot be guaranteed. Therefore Survey Solutions cannot be held responsible for any features annotated as taken from records. TFR.

Depths obtained using electromagnetic or GPR are affected by ground conditions and should be treated as indicative only. Electro-magnetic depths to utilities and services are generally taken to the centre of a feature. GPR depths to the top of a feature and drainage depth shown to invert, unless otherwise indicated.

Drainage pipe sizes will be obtained without entering the chamber and therefore should be treated as approximate. Pipe dimensions which have not been obtained usually will be taken from records when available.

All services, drainage and utilities routes are assumed straight between access points, unless otherwise stated. The numbers of cables in runs will not be shown unless specifically indicated. All services are below ground unless indicated.

Services, utilities and features may not have been surveyed if obstructed or not reasonably visible or accessible at the time of survey.

Survey Solutions accept no responsibility for the completeness or accuracy of either the topographical survey or base mapping on this project.

All critical dimensions and measurements should be checked and verified with any errors or discrepancies notified to Survey Solutions immediately. The accuracy of the digital data is the same as the plotting scale implies. All dimensions are in metres unless otherwise stated.

The contractor must check and verify all site and building dimensions, levels, utilities and drainage details and connections prior to commencing work.

© Land Survey Solutions Limited hold the copyright to all the information contained within this document and their written consent must be obtained before copying or using the data other than for the purpose it was originally supplied.

Do not scale from this drawing.

#### AVAILABILITY OF UTILITY RECORD DRAWINGS

UTILITY	AVAILABILITY	UTILITY	AVAILABILITY	UTILITY	AVAILABILITY
SEWER	SITE	ST	PUBLIC	ON PIPES	SITE
WATER MAIN	SITE	CABLE TV	SITE	OT ERS	NO
GAS MAIN	PUBLIC	ELECTRICITY	SITE		

REV	DESCRIPTION	DRAWN	APPR	DATE

**SURVEY SOLUTIONS**  
Ipswich Coventry Yeovil Norwich Perth Nottingham Brentwood

Tel No: 0 45 9405 161 Fax No: 0 45 9405 70  
www.survey-solutions.co.uk enquiries: survey@survey-solutions.co.uk

LAND SURVEYING BUILDING SURVEYING UNDERGROUND SURVEYING


PROJECT TITLE: WEST CAMBRIDGE DENSIFICATION SC. EME MADINGLEY ROAD, CB3 0EL  
DRAWING DETAIL: UTILITIES AND DRAINAGE INVESTIGATION  
S. EET 6 OF 2

CLIENT: PETER BRETT ASSOCIATES  
SCALE: 1:200

SURVEYOR: DWB/PM SURVEY DATE: C. IC. ED BY: RAG APPROVED BY: RAG DRG STATUS: FINAL

DRAWING NUMBER: 15415UG-06 REVISION: ISSUE DATE: APR 2015



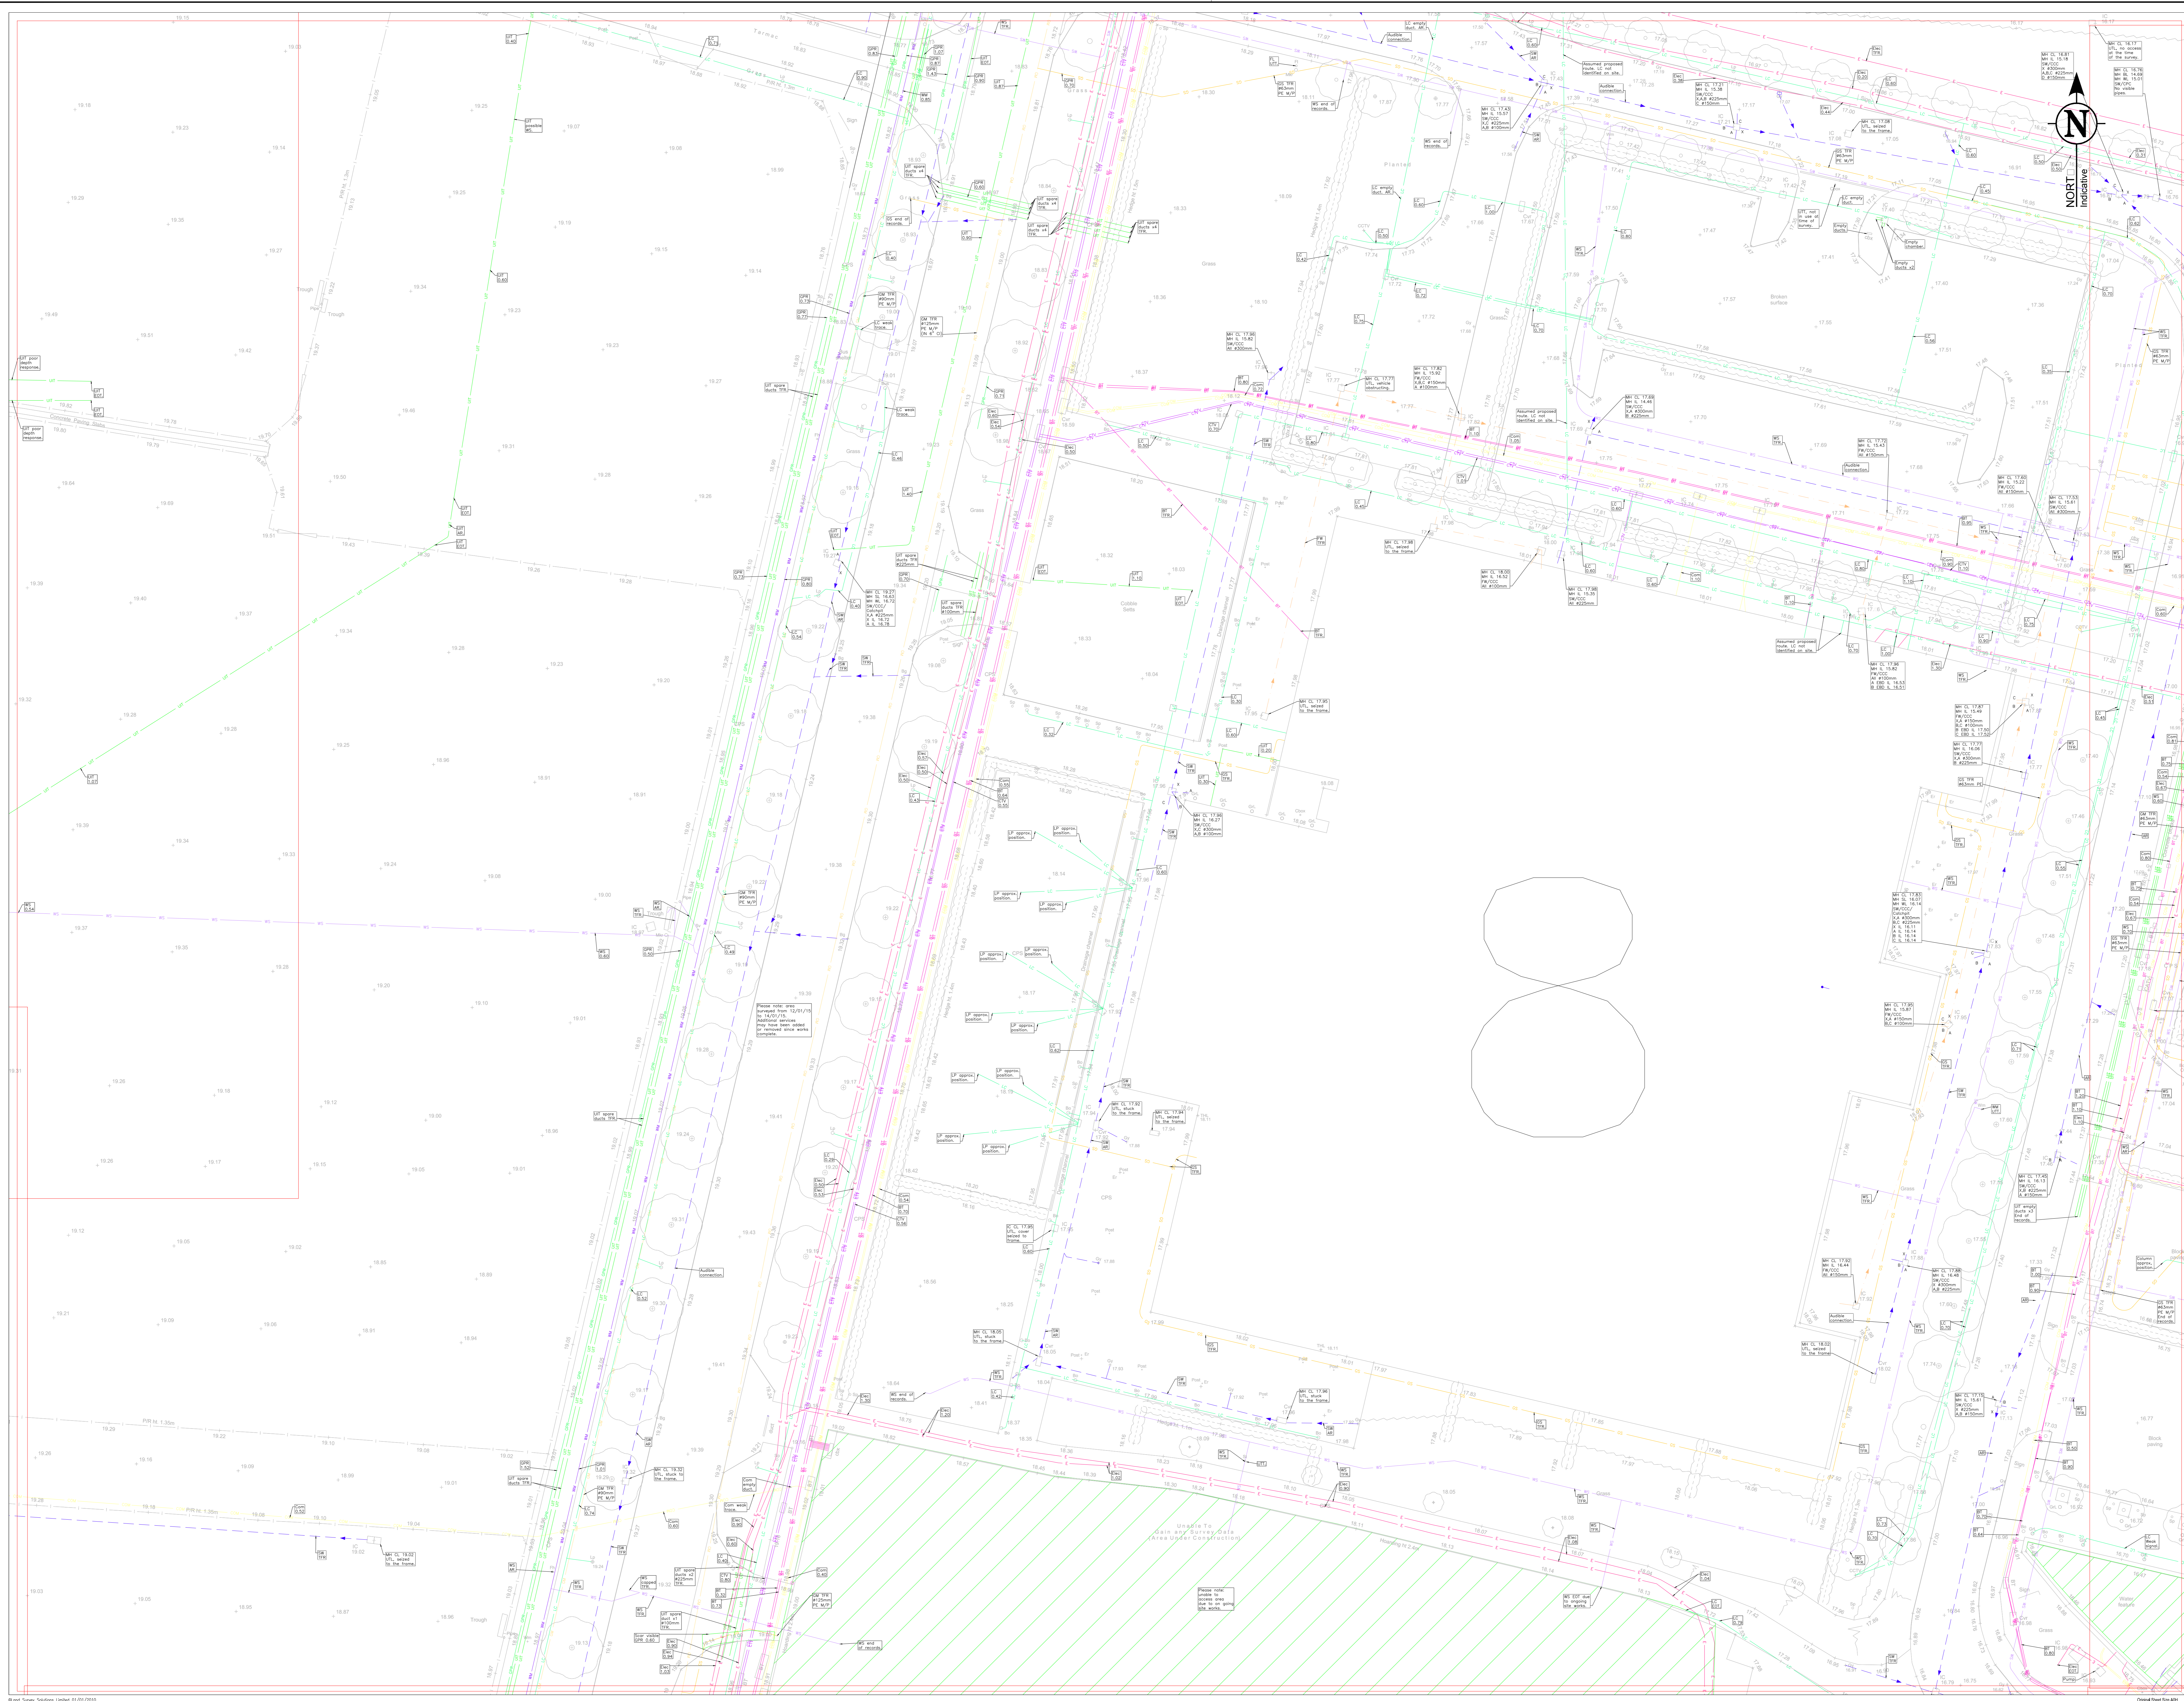

### ABBREVIATIONS & SYMBOLS

Abbreviation	Description
CD	Cable Chamber
CL	Cable Line
CC	Concrete Chamber

UTILITY COMMENT NO.

### DRAWING NOTES

All below ground details shown have been identified from above ground without excavation. Survey Solutions use electro-magnetic and/or ground penetrating radar (GPR) methods to investigate for underground utilities, services and features. Results using these methods are not definitive and it is recommended that excavations are carried out to confirm any identifications, positions and depths.

Any areas on the drawing where services or features have not been shown are not necessarily clear of services or features but are an indication that no items have been identified during our investigations. All reasonable care and normal good practice should still be employed during design and construction processes.

Certain types of services such as plastic or concrete pipes, some conduit and ducting where direct access can not be achieved for tracing may not be shown and alternative costing methods should be used.

Survey Solutions has used all reasonable care to research available service records, but the completeness or use of the service records supplied to or by Survey Solutions cannot be guaranteed. Therefore Survey Solutions cannot be held responsible for any features annotated as taken from records. TFR:

Depths obtained using electro-magnetic or GPR are affected by ground conditions and should be treated as indicative only. Electro-magnetic depths to utilities and services are generally taken to the centre of a feature. GPR depths to the top of a feature and drainage depth shown to invert, unless otherwise indicated.

Drainage pipe sizes will be obtained without entering the chamber and therefore should be treated as approximate. Pipe dimensions which have not been obtained usually will be taken from records when available.

All services, drainage and utility routes are assumed straight between access points unless otherwise stated. The number of cables in runs will not be shown unless specifically re-located. All services are below ground unless indicated.

Services, utilities and features may not have been surveyed if obstructed or not reasonably visible or accessible at the time of survey.

Survey Solutions accept no responsibility for the completeness or accuracy of either the topographical survey or base mapping on this project.

All critical dimensions and measurements should be checked and verified with any errors or discrepancies notified to Survey Solutions immediately. The accuracy of the digital data is the same as the plotting scale implies. All dimensions are in metres unless otherwise stated.

The contractor must check and verify all site and building dimensions, levels, utilities and drainage details and connections prior to commencing work.

© Land Survey Solutions Limited hold the copyright to all the information contained within this document and their written consent must be obtained before copying or using the data other than for the purpose it was originally supplied.

Do not scale from this drawing.

### AVAILABILITY OF UTILITY RECORD DRAWINGS

UTILITY	AVAILABILITY	UTILITY	AVAILABILITY	UTILITY	AVAILABILITY
SEWER	SITE	ST	PUBLIC	ON PIPES	SITE
WATER MAIN	SITE	CABLE TV	SITE	OT	ERS
GAS MAIN	PUBLIC	ELECTRICITY	SITE		



**SURVEY SOLUTIONS**  
Ipswich Coventry Yeovil Norwich Perth Nottingham Brentwood  
Tel No: 0 45 9405 11 Fax No: 0 45 9405 70  
www.surveysolutions.co.uk en: uk@surveysolutions.co.uk  
LAND SURVEYING BUILDING SURVEYING UNDERGROUND SURVEYING

PROJECT TITLE  
**WEST CAMBRIDGE DENIFICATION SC. EME  
MADINGLEY ROAD, CB3 0EL**

DRAWING DETAIL  
**UTILITIES AND DRAINAGE INVESTIGATION**  
S. EET. OF 2.

CLIENT  
PIETER BRETT ASSOCIATES

SURVEYOR  
DWRP1

SURVEY DATE  
03/11/2014

C. I. C. E. D.  
TM

APPROVED BY  
RAG



ENIG STATUS  
FINAL

DRAWING NUMBER  
1541SUG-0

REVISION

SCALE  
1:200

ISSUE DATE  
APR 2015

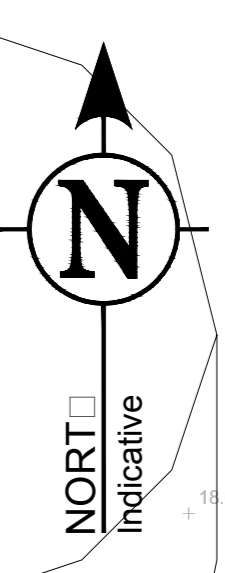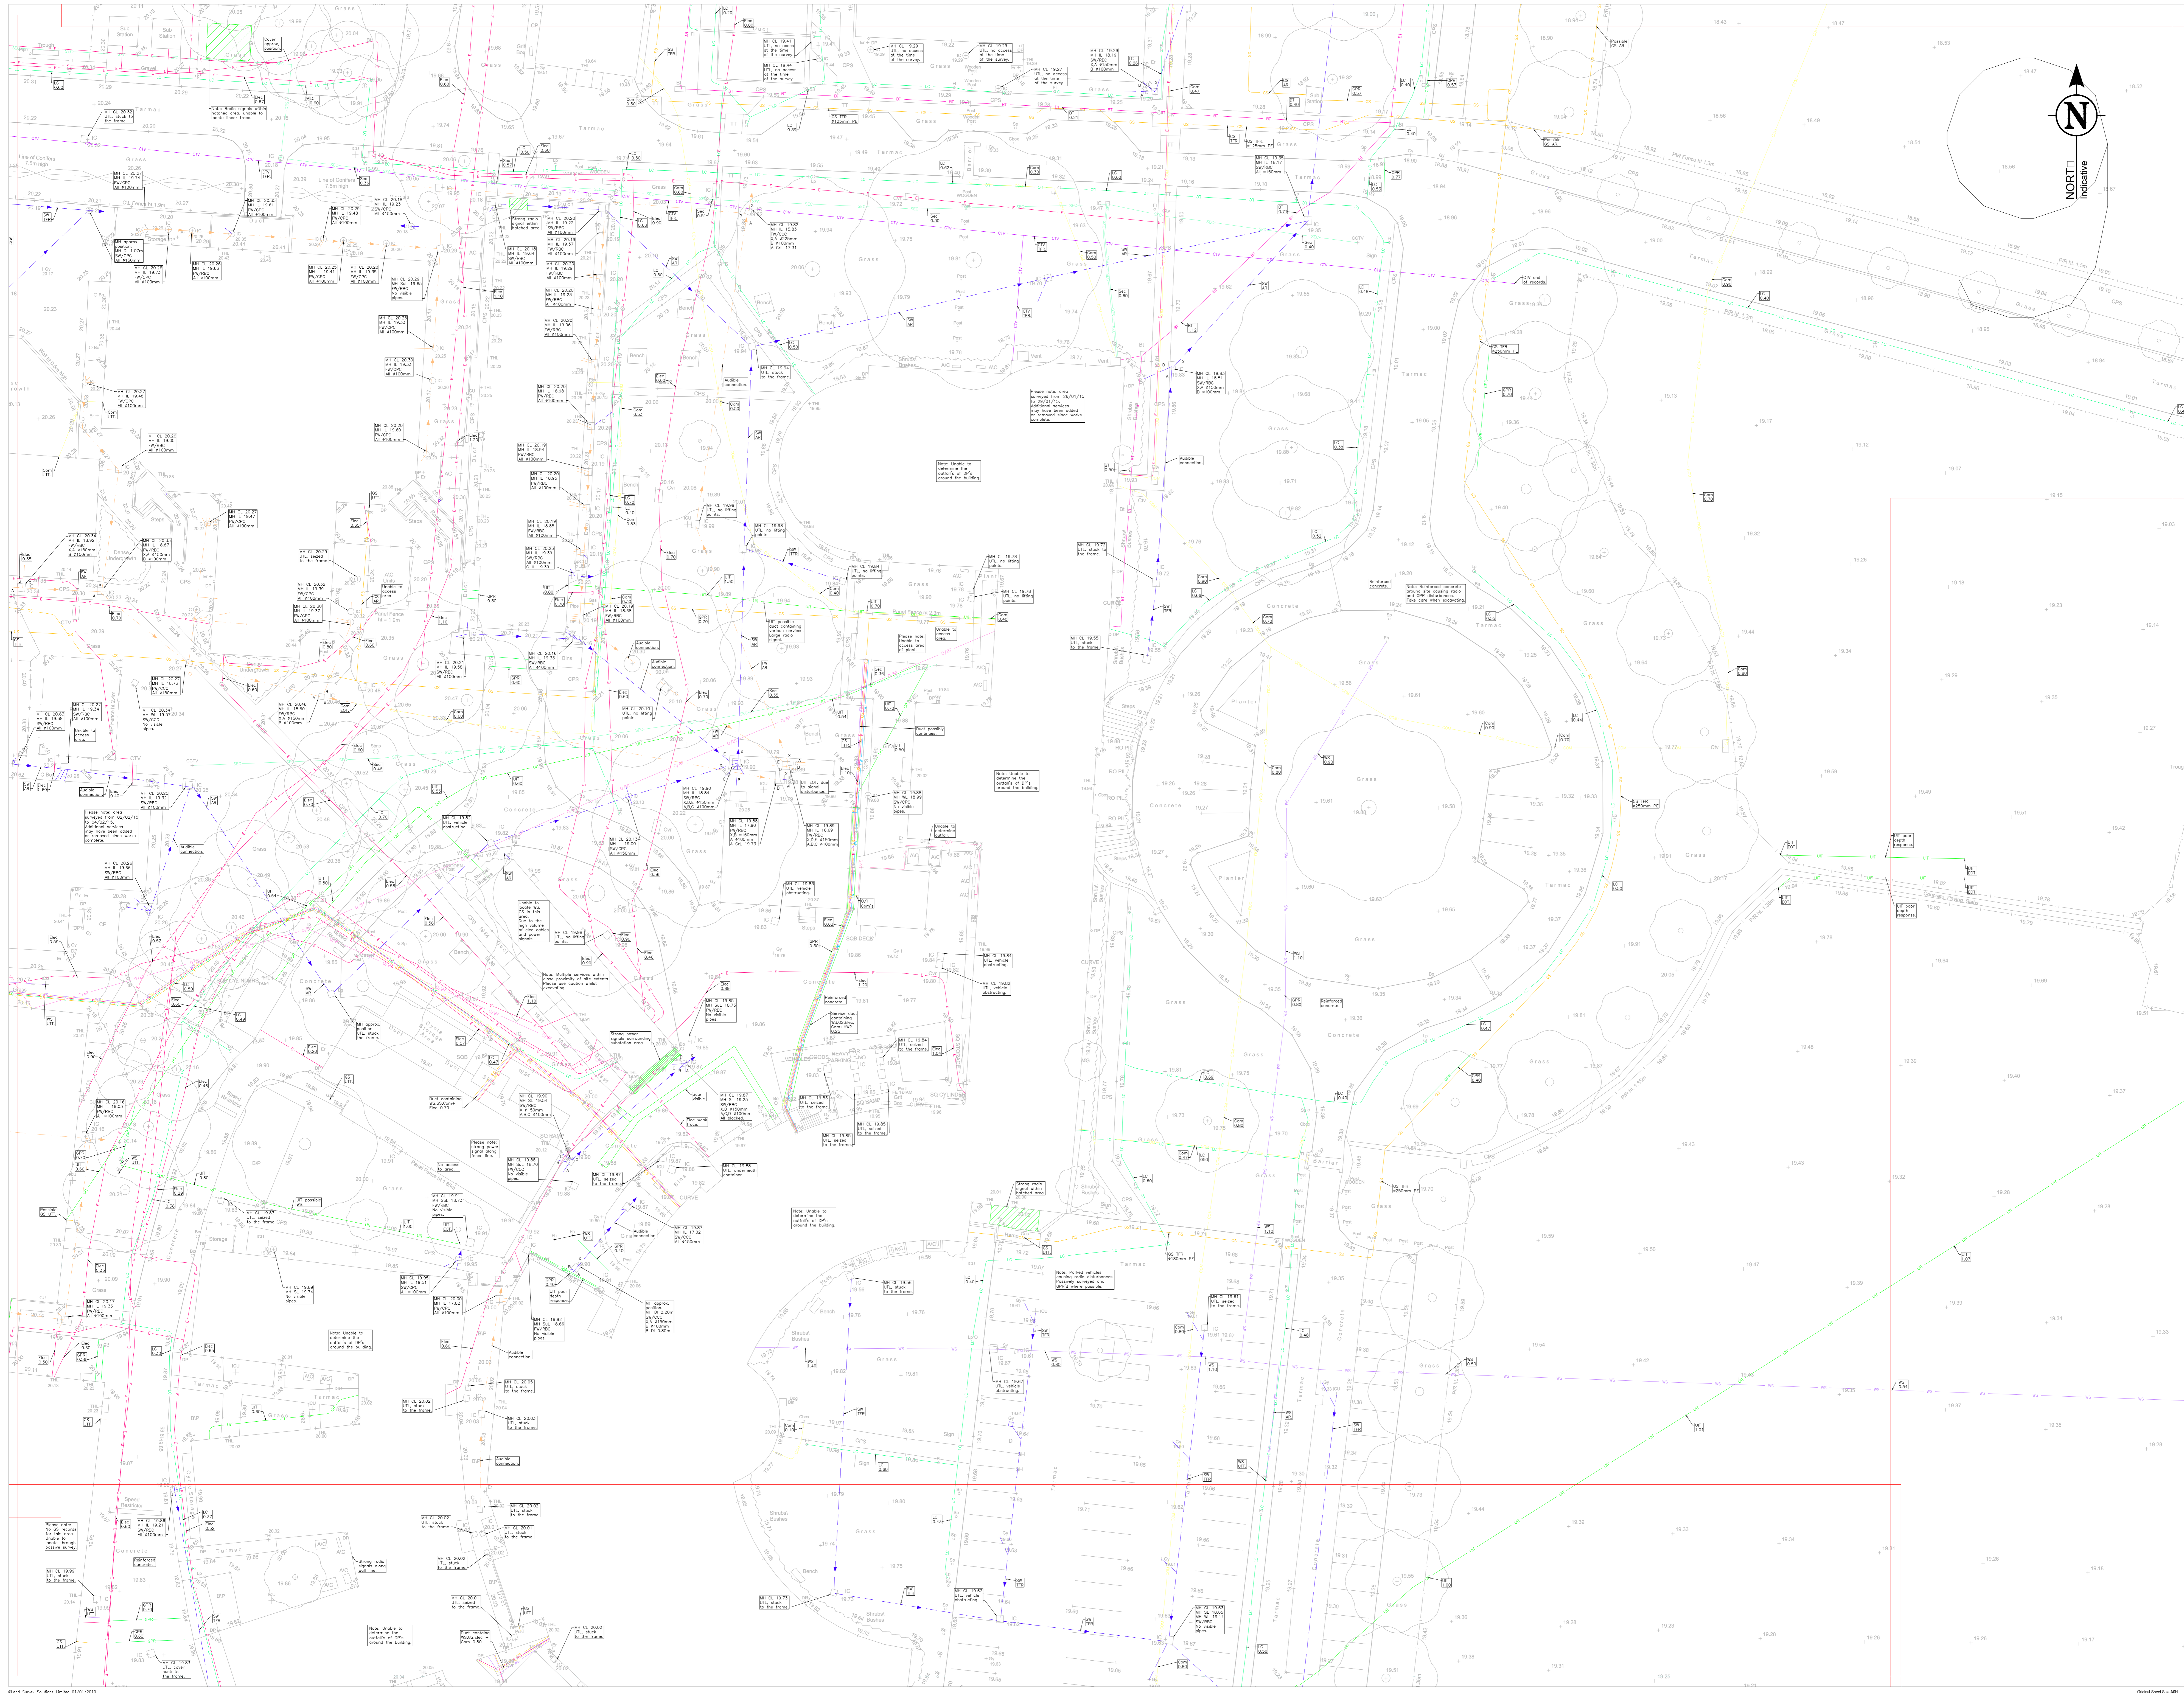

**ABBREVIATIONS & SYMBOLS**

10-DC	Duct Covers	CP	Cable Tray	ED	End of Trace
AS	Asphalt	DO	Down to level	E	Electrical
BL	Base Level	DS	Down to surface	RS	Reinforced Concrete
CB	Concrete Base	DT	Down to top	RCS	Rear Garden Cover
CC	Concrete Cover	DTL	Down to level	SL	Surface Level
CC	Concrete Cover	DTW	Down to water	UL	Under Level
GL	Ground Level	EL	Electricity	UTL	Under to level

**DRAWING NOTES**

All below ground details shown have been identified from above ground without excavation. Survey Solutions use electro-magnetic and/or ground penetrating radar (GPR) methods to investigate underground utilities, services and features. Results using these methods are not infallible and it is recommended that excavations are carried out to confirm any identifications, positions and depths.

Any areas on the drawing where services or features have not been shown are not necessarily clear of services or features but are an indication that no items have been identified during our investigations. All reasonable care and normal good practice should still be employed during design and construction processes.

Certain types of services such as plastic or concrete pipes, some conduit and cabling where direct access cannot be achieved for tracing may not be shown and alternative costing methods should be used.

Survey Solutions has used all reasonable care to research available service records, but the completeness or use of the service records supplied to or by Survey Solutions cannot be guaranteed. Therefore Survey Solutions cannot be held responsible for any features annotated as taken from records. TFR.

Depths obtained using electro-magnetic or GPR are affected by ground conditions and should be treated as indicative only. Electro-magnetic depths to utilities and services are generally taken to the centre of a feature. GPR depths to the top of a feature and drainage depth shown to invert, unless otherwise indicated.

Drainage pipe sizes will be obtained without entering the chamber and therefore should be treated as approximate. Pipe dimensions which have not been obtained usually will be taken from records when available.

All services, drainage and utility routes are assumed straight between access points unless otherwise stated. The numbers of cables in runs will not be shown unless specifically indicated. All services are below ground unless indicated.

Services, utilities and features may not have been surveyed if obstructed or not reasonably visible or accessible at the time of survey.

Survey Solutions accept no responsibility for the completeness or accuracy of either the topographical survey or base mapping on this project.

All critical dimensions and measurements should be checked and verified with any errors or discrepancies notified to Survey Solutions immediately. The accuracy of the digital data is the same as the plotting scale implies. All dimensions are in metres unless otherwise stated.

The contractor must check and verify all site and building dimensions, levels, utilities and drainage details and connections prior to commencing work.

© Land Survey Solutions Limited hold the copyright to all the information contained within this document and their written consent must be obtained before copying or using the data other than for the purpose it was originally supplied.

Do not scale from this drawing.

**AVAILABILITY OF UTILITY RECORD DRAWINGS**

UTILITY	AVAILABILITY	UTILITY	AVAILABILITY	UTILITY	AVAILABILITY

REV	DESCRIPTION	DRAWN	APPR	DATE

**SURVEY SOLUTIONS**  
 Ipswich Coventry Yeovil Norwich Perth Nottingham Brentwood

Tel No: 0 45 2405 1 E Fax No: 0 45 2405 70  
 www.survey-solutions.co.uk email: survey@survey-solutions.co.uk

LAND SURVEYING BUILDING SURVEYING UNDERGROUND SURVEYING

PROJECT FILE: WEST CAMBRIDGE DENSIFICATION SC. EME MADINGLEY ROAD, CB3 0EL


DRAWING DETAIL: UTILITIES AND DRAINAGE INVESTIGATION

SHEET OF 2

CLIENT: PETER BRETT ASSOCIATES

SURVEYOR: DW/PR1 SURVEY DATE: C/C BY: TM APPROVED BY: RAG

DRAWING NUMBER: 1541-SUG-0 REVISION: ISSUE DATE: APR 2015

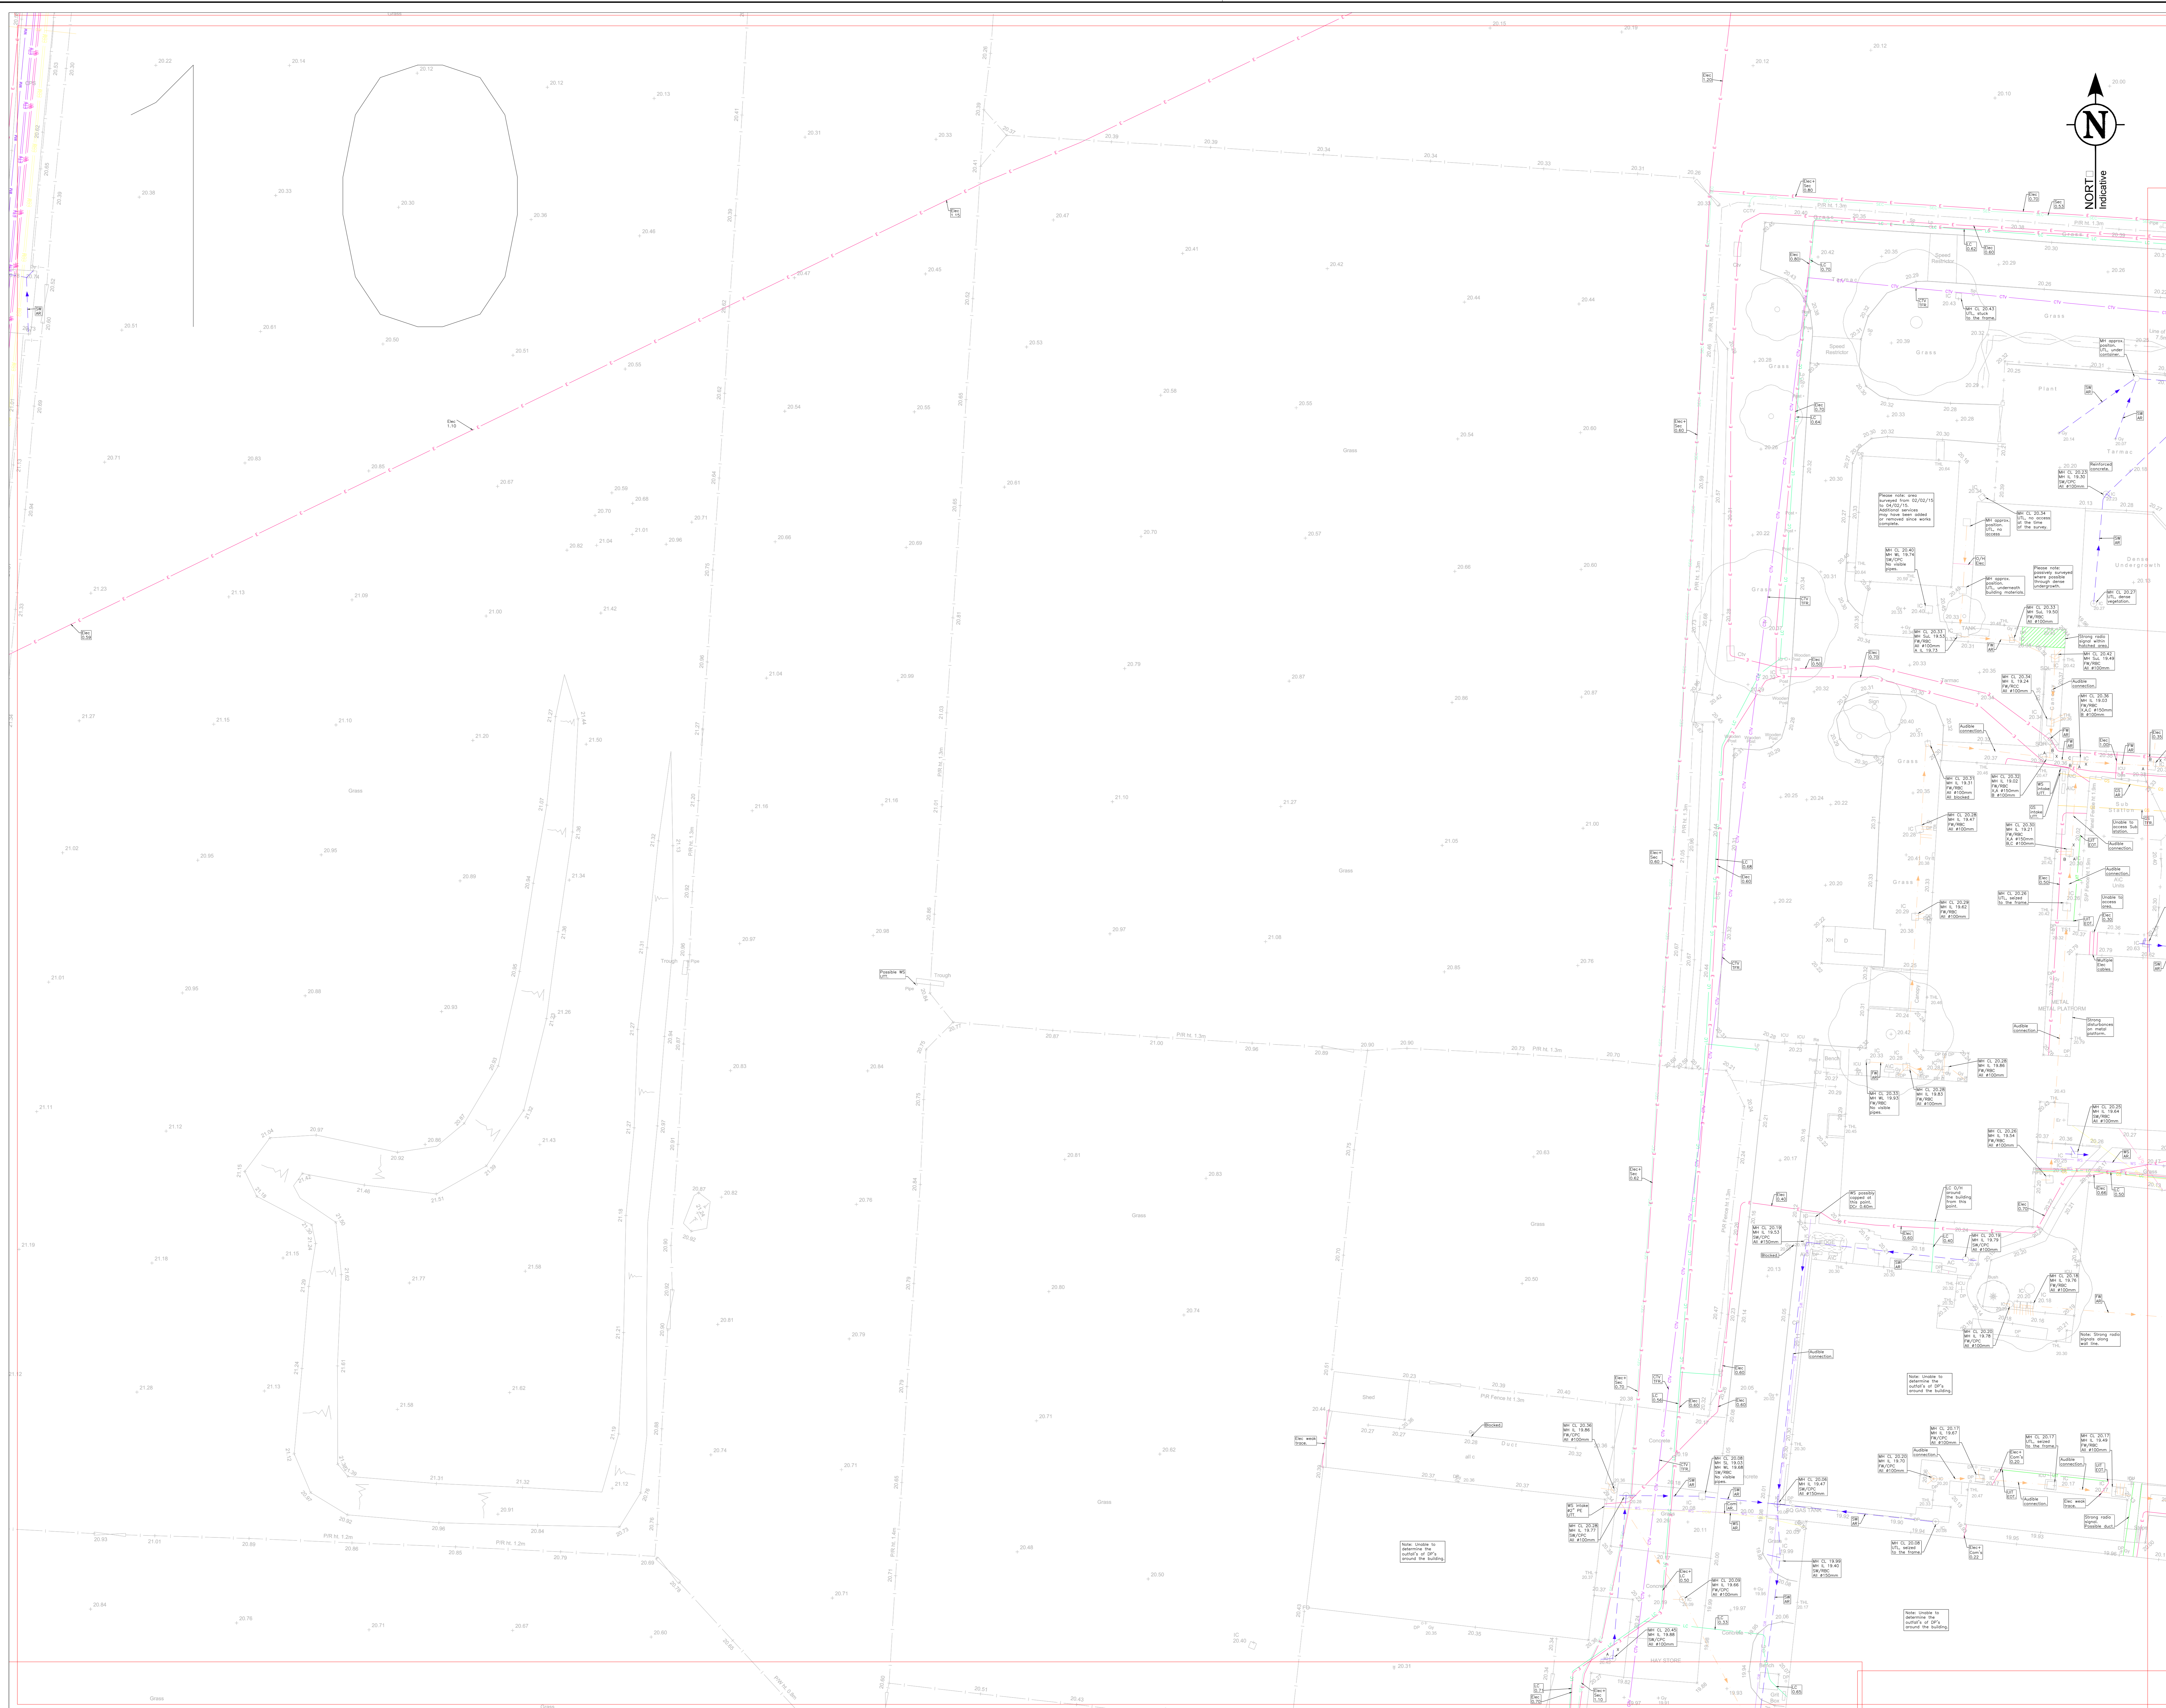

**UTILITIES - UNDERGROUND INVESTIGATIONS**

**ABBREVIATIONS & SYMBOLS**

0-10	Drain Chamber	GP	Cable Chamber	EQ	End of Trace
0-20	Drain	GL	Cable Line	ES	Electric Service
AR	Asphalt Road	DD	Drain To Down	ET	End of Trace
BL	Base Level	DS	Drain To Street	ES	Electric Service
CB	Concrete Banding	DT	Drain To Terrace	GC	Gas Control Chamber
CCC	Concrete Core Chamber	DW	Drain To Waste	GL	Ground Level

**DRAWING NOTES**

All below ground details shown have been identified from above ground without excavation. Survey Solutions use electro-magnetic and/or ground penetrating radar (GPR) methods to investigate for underground utilities, services and features. Results using these methods are not infallible and we recommend that excavations are carried out to confirm any identifications, positions and depths.

Any areas on the drawing where services or features have not been shown are not necessarily clear of services or features but are an indication that no items have been identified during our investigations. All reasonable care and normal good practice should still be employed during design and construction processes.

Certain types of services such as plastic or concrete pipes, some conduit and cabling where direct access can not be achieved for tracing may not be shown and alternative locating methods should be used.

Survey Solutions has used all reasonable care to research available service records, but the completeness or use of the service records supplied to or by Survey Solutions cannot be guaranteed. Therefore Survey Solutions cannot be held responsible for any features annotated as taken from records. TFR.

Depths obtained using electro-magnetic or GPR are effected by ground conditions and should be treated as indicative only. Electro-magnetic depths to utilities and services are generally taken to the centre of a feature. GPR depths to the top of a feature and drainage depth shown to invert, unless otherwise indicated.

Drainage pipes at 1m will be obtained without entering the chamber and therefore should be treated as approximate. Pipe dimensions which have not been obtained usually will be taken from records when available.

All services, drainage and utilities routes are assumed straight between access points unless otherwise stated. The numbers of cables in runs will not be shown unless specifically required. All services are below ground unless indicated.

Services, utilities and features may not have been surveyed if obstructed or not reasonably visible or accessible at the time of survey.

Survey Solutions accept no responsibility for the completeness or accuracy of either the topographical survey or base mapping on this project.

All critical dimensions and measurements should be checked and verified with any errors or discrepancies notified to Survey Solutions immediately. The accuracy of the digital data is the same as the plotting scale implies. All dimensions are in metres unless otherwise stated.

The contractor must check and verify all site and building dimensions, levels, utilities and drainage details and connections prior to commencing work.

© Land Survey Solutions Limited hold the copyright to all the information contained within this document and their written consent must be obtained before copying or using the data other than for the purpose it was originally supplied.

Do not scale from this drawing.

**AVAILABILITY OF UTILITY RECORD DRAWINGS**

UTILITY	AVAILABILITY	UTILITY	AVAILABILITY	UTILITY	AVAILABILITY
SEWER	SITE	BT	PUBLIC	ON FERRY	SITE
WATER MAIN	SITE	CABLE TV	SITE	OT	ERS
GAS MAIN	PUBLIC	ELECTRICITY	SITE		

REV	DESCRIPTION	DRAWN	APPR	DATE

**SURVEY SOLUTIONS**

Ipswich Coventry Yeovil Norwich Perth Nottingham Brentwood


Tel No: 0145 540051 E: sales@solutions.co.uk  
 www.solutions.co.uk en: info@solutions.co.uk

LAND SURVEYING BUILDING SURVEYING UNDERGROUND SURVEYING

PROJECT TITLE:  
WEST CAMBRIDGE DENIFICATION SC, EME  
MADINGLEY ROAD, CB3 0EL

DRAWING DETAIL:  
UTILITIES AND DRAINAGE INVESTIGATION  
SHEET 10 OF 2

CLIENT:	PETER BRETT ASSOCIATES	SCALE:	1:200
SURVEYOR:	DWR/PI	SURVEY DATE:	C EC ED BY RAG
DRAWING NUMBER:	03110214 TM	APPROVED BY:	ENG STATUS
		REVISION:	FINAL
		ISSUE DATE:	APR 2015

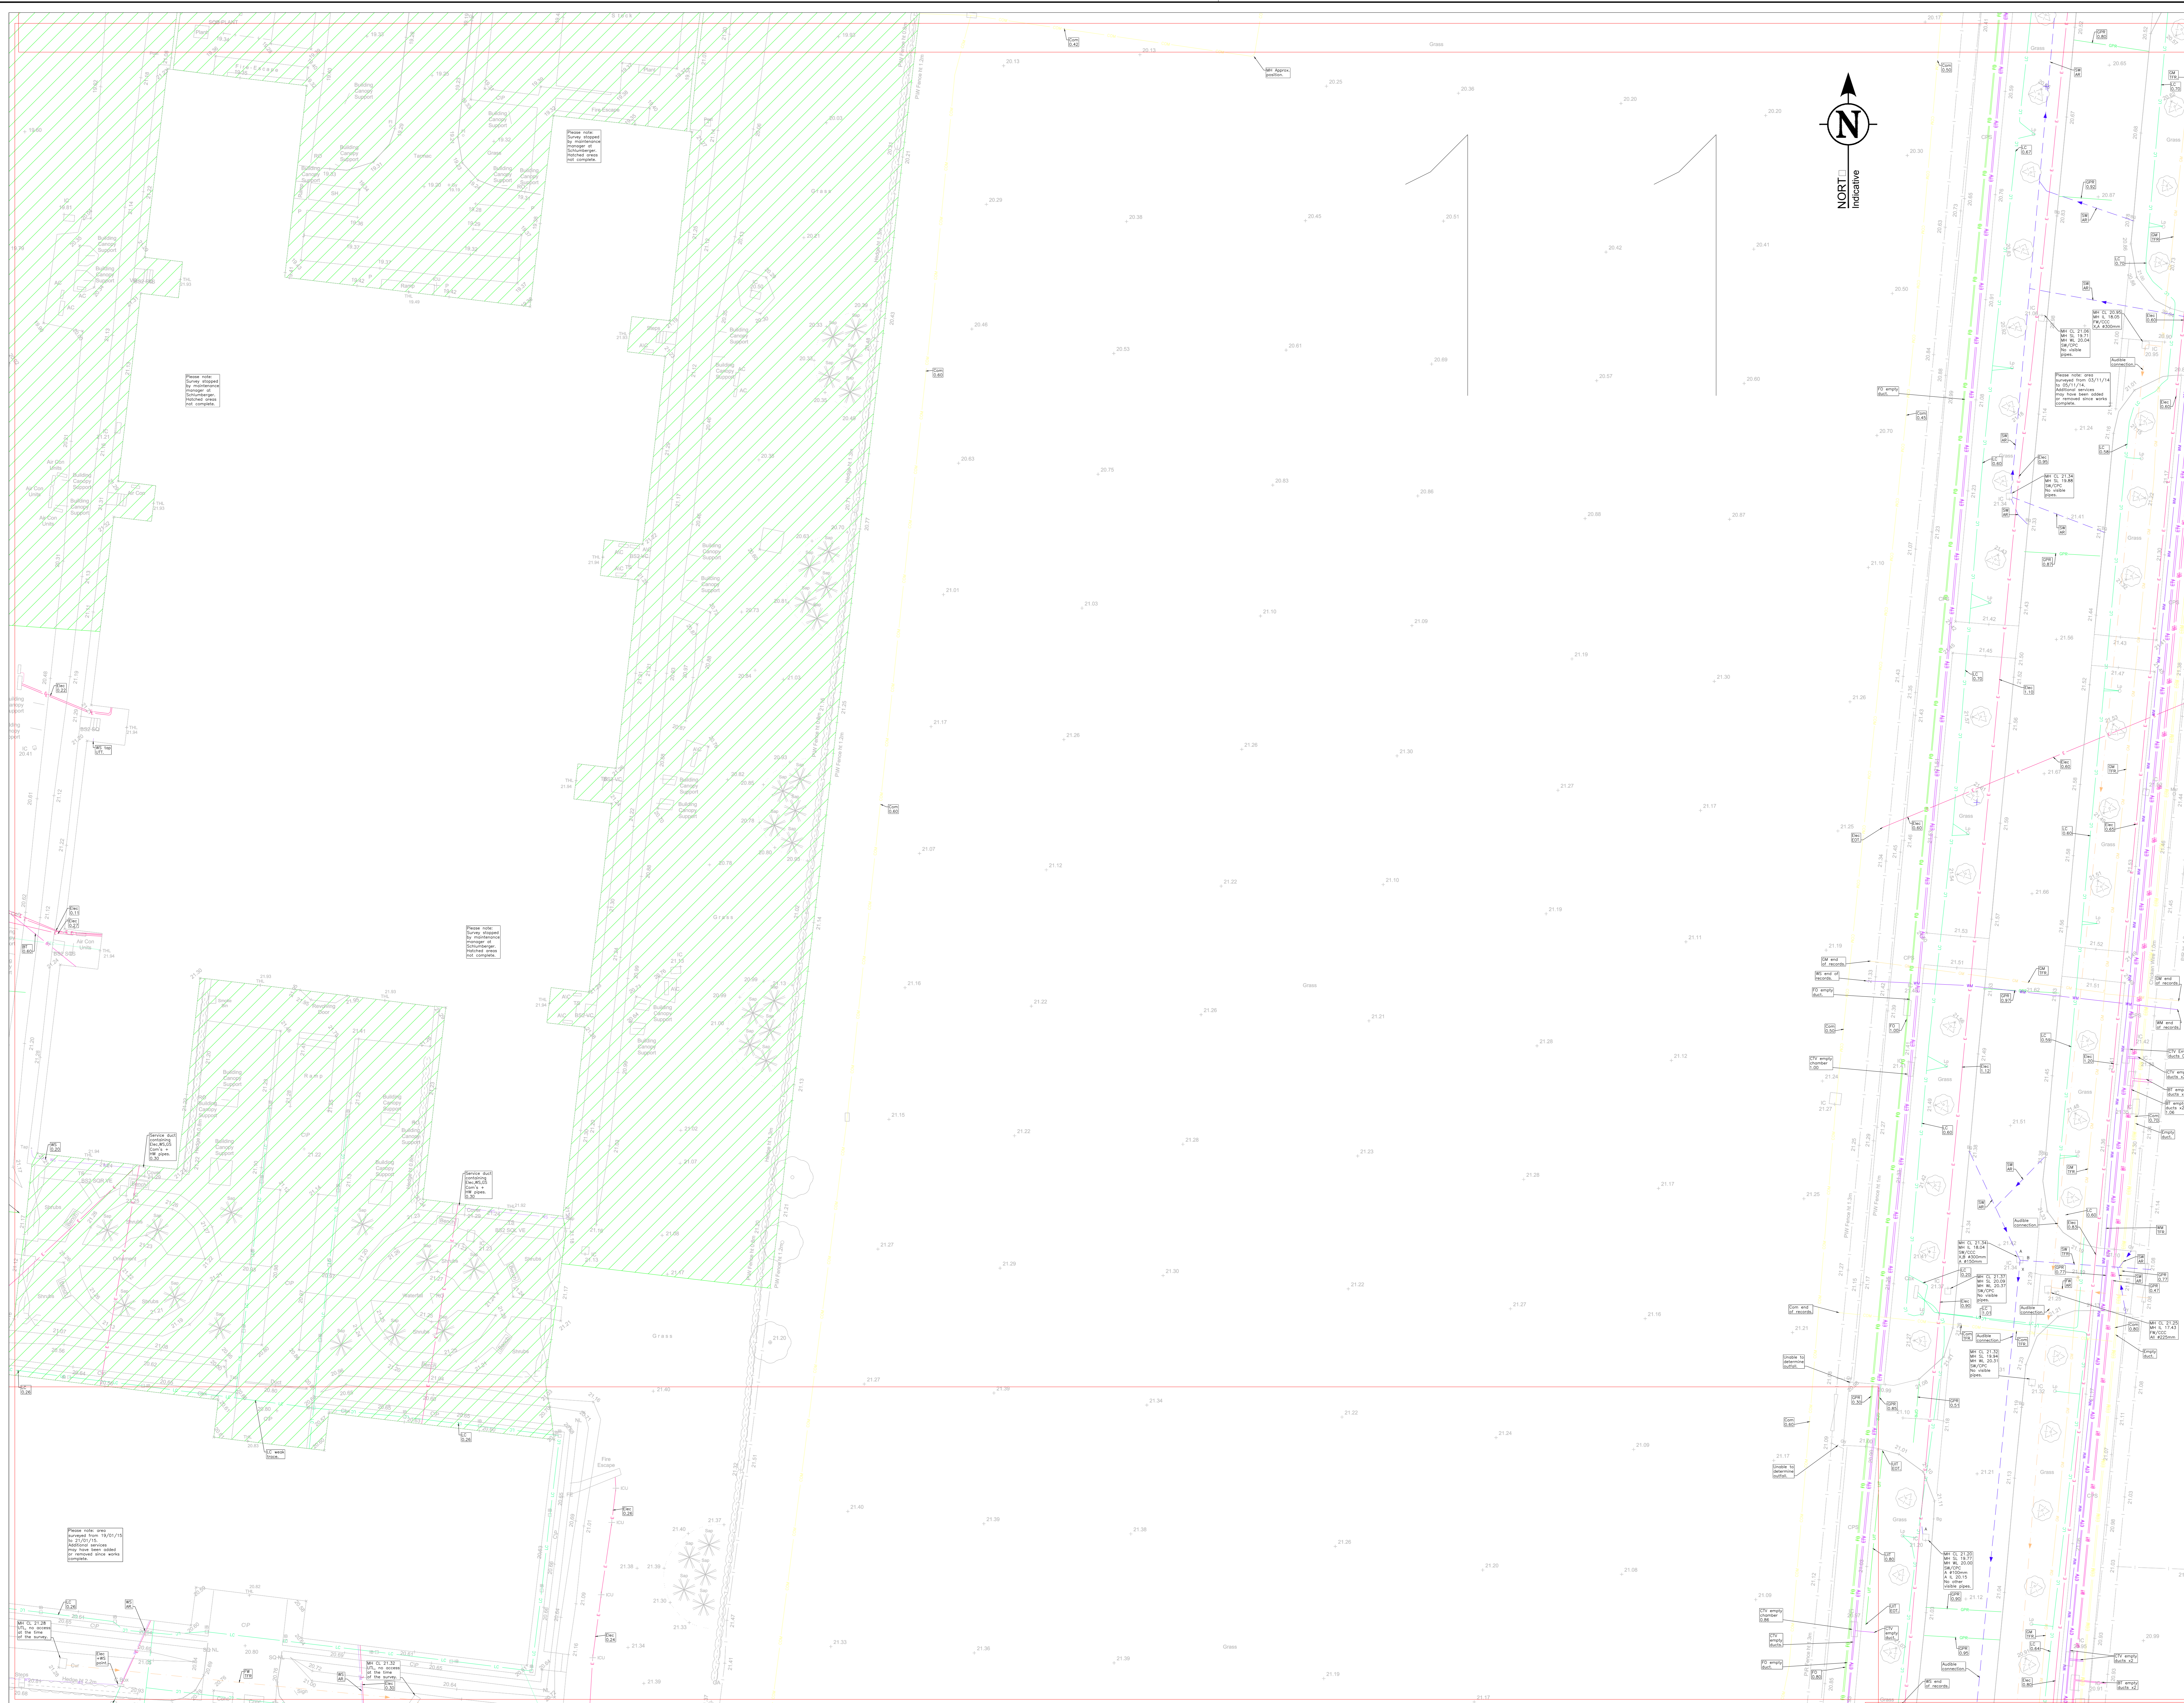

**ABBREVIATIONS & SYMBOLS**

CB	Concrete Base	DR	Down To Rise	RC	Rise To Concrete

**DRAWING NOTES**

All below ground details shown have been identified from above ground without excavation. Survey Solutions use electro-magnetic and/or ground penetrating radar (GPR) methods to investigate for underground utilities, services and features. Results using these methods are not infallible and we recommend that excavations are carried out to confirm any identifications, positions and depths.

Any areas on the drawing where services or features have not been shown are not necessarily clear of services or features but are an indication that no items have been identified during our investigations. All reasonable care and normal good practice should still be employed during design and construction processes.

Certain types of services such as plastic or concrete pipes, some conduit and ducting where direct access can not be achieved for tracing may not be shown and alternative costing methods should be used.

Survey Solutions has used all reasonable care to research available service records, but the completeness or use of the service records supplied to or by Survey Solutions cannot be guaranteed. Therefore Survey Solutions cannot be held responsible for any features annotated as taken from records. TFR.

Depths obtained using electro-magnetic or GPR are affected by ground conditions and should be treated as indicative only. Electro-magnetic depths to utilities and services are generally taken to the centre of a feature. GPR depths to the top of a feature and drainage depth shown to invert, unless otherwise indicated.

Drainage pipe sizes will be obtained without entering the chamber and therefore should be treated as approximate. Pipe dimensions which have not been obtained usually will be taken from records when available.

All services, drainage and utilities routes are assumed straight between access points unless otherwise stated. The numbers of cables in runs will not be shown unless specifically re-located. All services are below ground unless indicated.

Services, utilities and features may not have been surveyed if obstructed or not reasonably visible or accessible at the time of survey.

Survey Solutions accept no responsibility for the completeness or accuracy of either the topographical survey or base mapping on this project.

All critical dimensions and measurements should be checked and verified with any errors or discrepancies notified to Survey Solutions immediately. The accuracy of the digital data is the same as the plotting scale implies. All dimensions are in metres unless otherwise stated.

The contractor must check and verify all site and building dimensions, levels, utilities and drainage details and connections prior to commencing work.

© Land Survey Solutions Limited hold the copyright to all the information contained within this document and their written consent must be obtained before copying or using the data other than for the purpose it was originally supplied.

Do not scale from this drawing.

**AVAILABILITY OF UTILITY RECORD DRAWINGS**

UTILITY	AVAILABILITY	UTILITY	AVAILABILITY	UTILITY	AVAILABILITY
SEWER	SITE	ST	PUBLIC	ON PAPER	SITE
WATER MAIN	SITE	CABLE TV	SITE	OT ERS	NO
GAS MAIN	PUBLIC	ELECTRICITY	SITE		

**SURVEY SOLUTIONS**  
 Ipswich Coventry Yeovil Norwich Perth Nottingham Brentwood

Tel No: 0 45 9405 1 E Fax No: 0 45 9405 70  
 www.surveysolutions.co.uk en USURF: survey-solutions.co.uk

LAND SURVEYING BUILDING SURVEYING UNDERGROUND SURVEYING

PROJECT TITLE: WEST CAMBRIDGE DENSIFICATION SC. EME MADINGLEY ROAD, CB3 0EL  
 DRAWING DETAIL: UTILITIES AND DRAINAGE INVESTIGATION  
 S. EET 11 OF 2

CLIENT: PETER BRETT ASSOCIATES  
 SURVEYOR: DW/PH SURVEY DATE: C 15/03/11 APPROVED BY: RAG  
 DRAWING NUMBER: 15415UG-11 REVISION: ISSUE DATE: APR 2015

